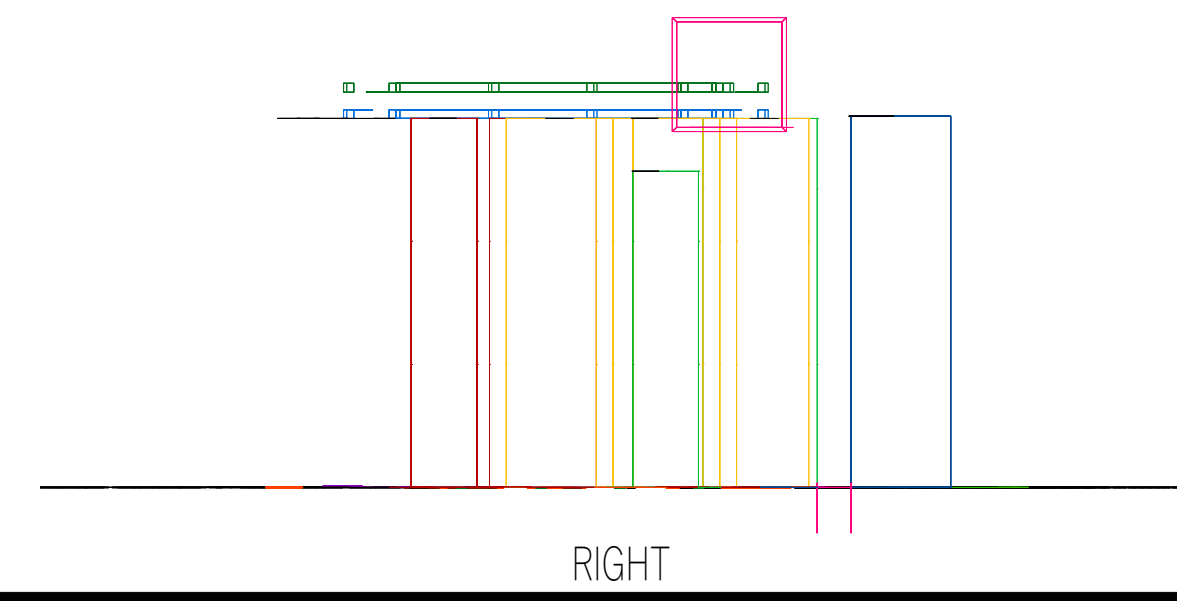
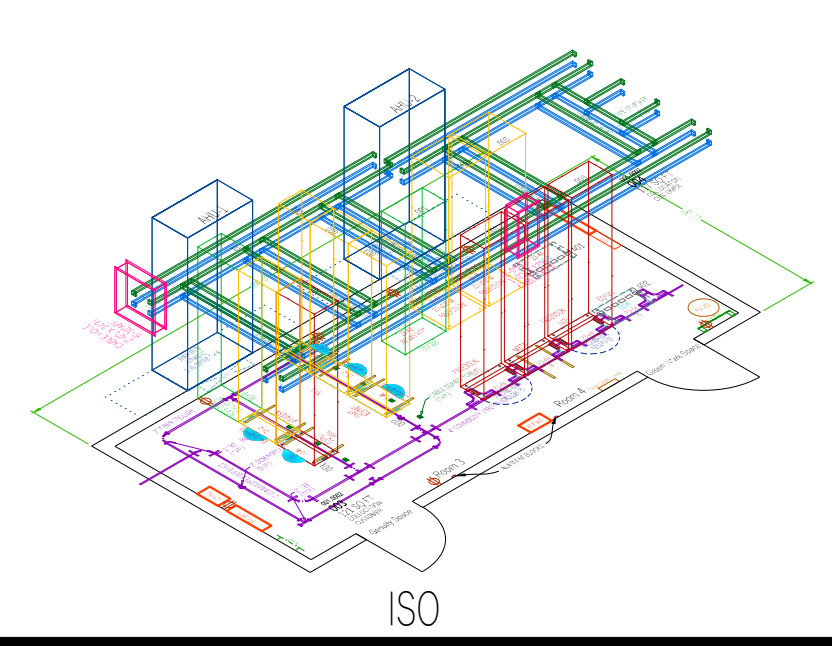
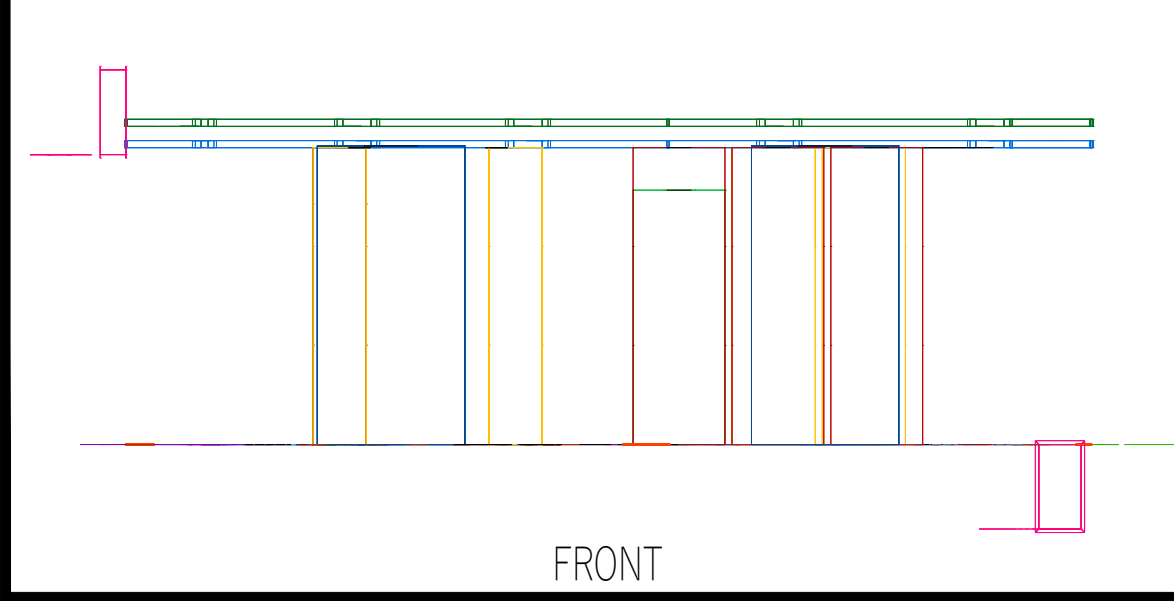
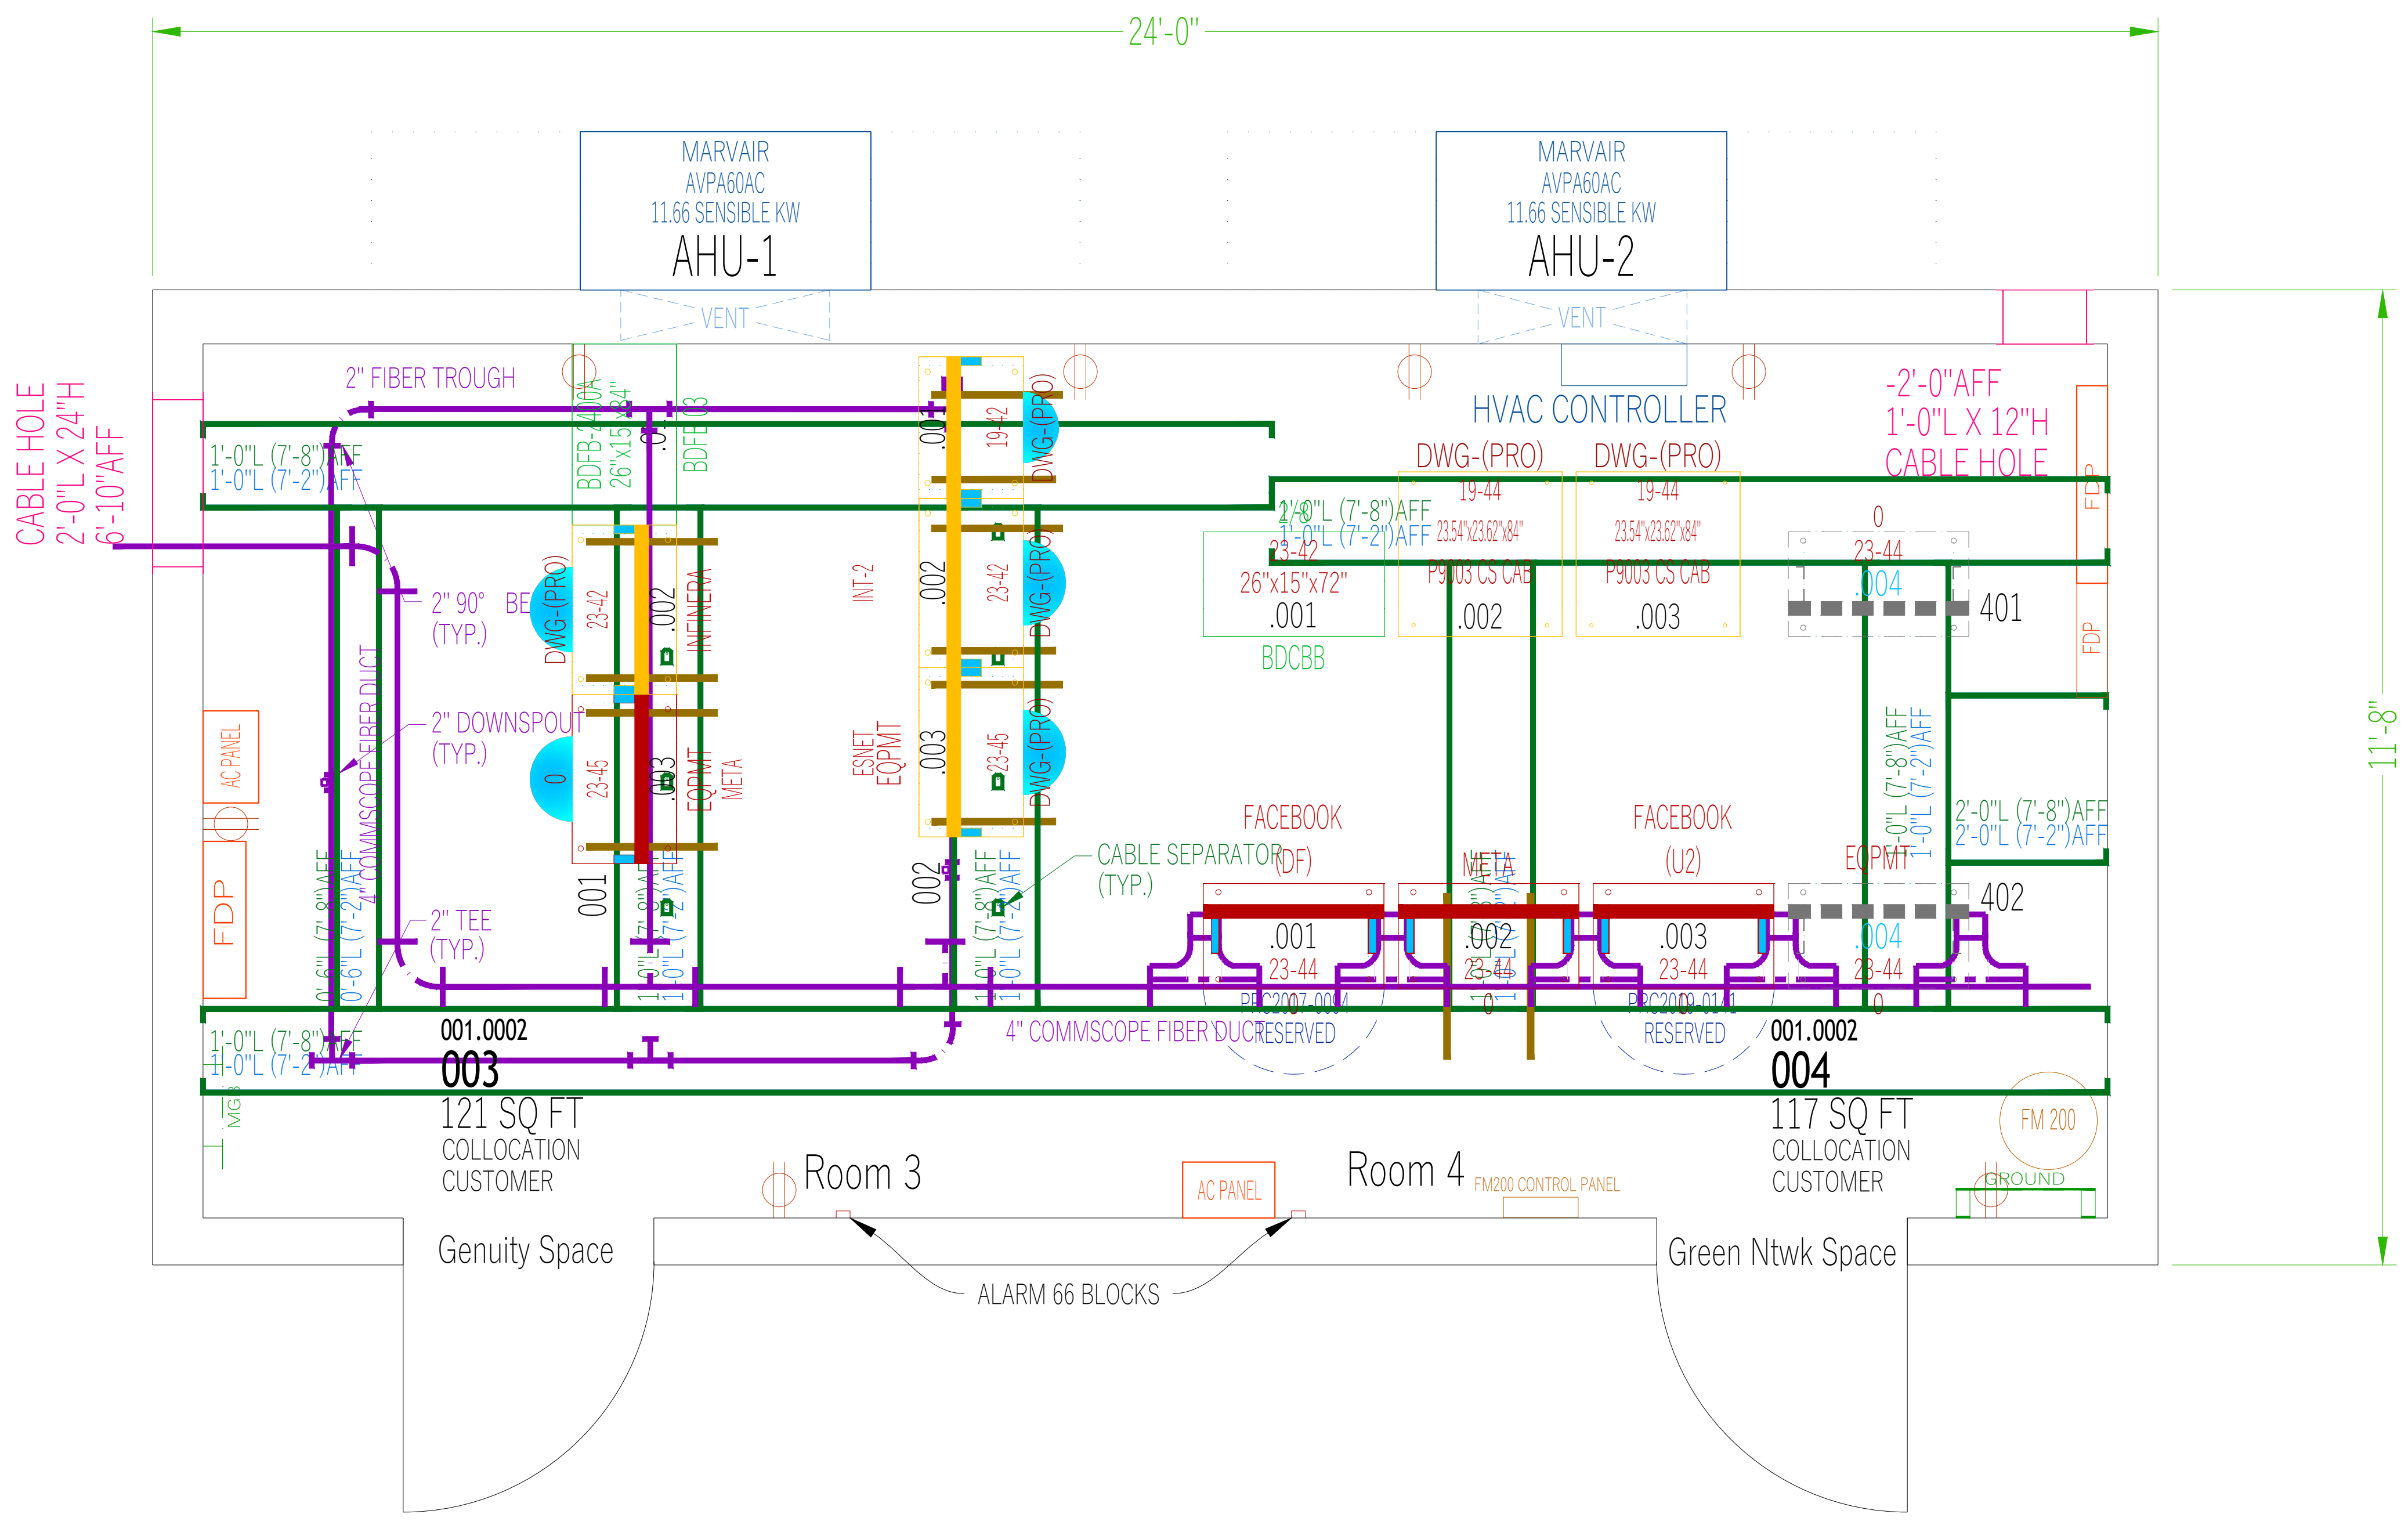


VERSIONS

VERSION: 1	DATE: 26Sep18	ENG:	PM:	DRAFT: Auto
CREATED FROM DGN FILE(S) IN AUTOMATED PROCESS: 488200002.dgn, 488100002.dgn				
VERSION: 2	DATE: 14PR19	ENG: EJ	PM: TD	DRAFT: CH
UPDATE THE BUILDING ASBUILT AND RESERVE RRO401.04, 0402.02, AND 0402.03 PER PRC2019-0141				
VERSION: 3	DATE: 12APR19	ENG: EJ	PM: TD	DRAFT: CH
IDENTIFY RRO401.02/.03 AS INSTALLED PER PRC2017-0575				
VERSION: 4	DATE: 30MAR22	ENG:	PM:	DRAFT: KWW
COMBINED INTO THIS DRAWING. DRAWINGS CSRKCOOH-FP-01-01-GN AND CSRKCOOF-FP-04-01-CN. CSRKCOOH IS THE SAME SITE, AND THERE ARE ONLY (2) HUTS INSTEAD OF (4) - HUT#2 HAS ROOMS 3 AND 4. MOVED DRAWINGS TO ASSOCIATED ARCH FOLDERS. THERE ARE DISCREPANCIES BETWEEN THIS DRAWING, PRO, AND THE OTHER (2) DRAWINGS, WHICH ARE CURRENTLY UNRESOLVED. COPIED REVISION NOTES FROM OTHER DRAWINGS. CORRECTED FILE NAME TO INDICATE 2ND BUILDING (INSTEAD OF 2ND FLR) -FP-01-02-1.				
VERSION: 7	DATE: 9MAY22	ENG: JPM	PM: JAF	DRAFT: CH
CTL TO INSTALL 1RR EQPT RR 0402.02 WILL SUPPORT DF CUSTOMER, META(FACEBOOK). PRC2019-0141 CSS # FACEBOOKPCNRLNRFLUEF N78215				
VERSION: 8	DATE: 23NOV22	ENG: JPM	PM: JAF	DRAFT: JPM
ADD 4" FIBER DUCT AND DROPS PER MADISON AS-BUILTS. W.O. # CSRKCOOF-IN-Fiberduct-01 CSS # N/A N674026				
VERSION: 9	DATE: 12FEB24	ENG:	PM:	DRAFT: KWW
CORRECT FILE NAME INDICATING BUILDING #2 INSTEAD OF FLOOR #2.				
VERSION: 10	DATE: 14MAR24	ENG: JPM	PM: JAF	DRAFT: JPM
INSTALL (1) CTL TELCO UEF RELAY RACK IN ROOM 001.0002.003, RACK POSITION 001.003 FOR META. W.O. # CSRKCOOF-COI-FB(Meta)-R&P01 CSS # META00FPNRLNRIF N866317				
VERSION: 11	DATE: 19NOV25	ENG:	PM:	DRAFT: KWW
UPDATE BLOCKS WITH PRO DATA AND UPDATE LAYERS AND PAPERSPACE LAYOUT.				

LUMEN®

INFORMATION IN THIS DOCUMENT IS PROPRIETARY AND SHALL NOT BE USED, COPIED, REPRODUCED, OR DISCLOSED IN WHOLE OR IN PART WITHOUT WRITTEN CONSENT OF LUMEN TECHNOLOGIES LLC.

APPROVAL 1:	DATE:	CLIENT CODE/ADDRESS:
		CSRKCOOF Floor = 01
DRAWN BY:		182 PRAIRIE HAWK DR @ MP 70512 BNSF CASTLE ROCK, CO
		KWW Automated
SIZE:	DRAWING TITLE:	
D	FLOOR PLAN - 488 - BLDG-2	
CEILING POST:	DRAWING NUMBER:	REVISION:
?	CSRKCOOF-FP-01-02-CN	11
SCALE:	RELEASED:	SHEET:
3/4"=1'	11/19/25	1 OF 1