
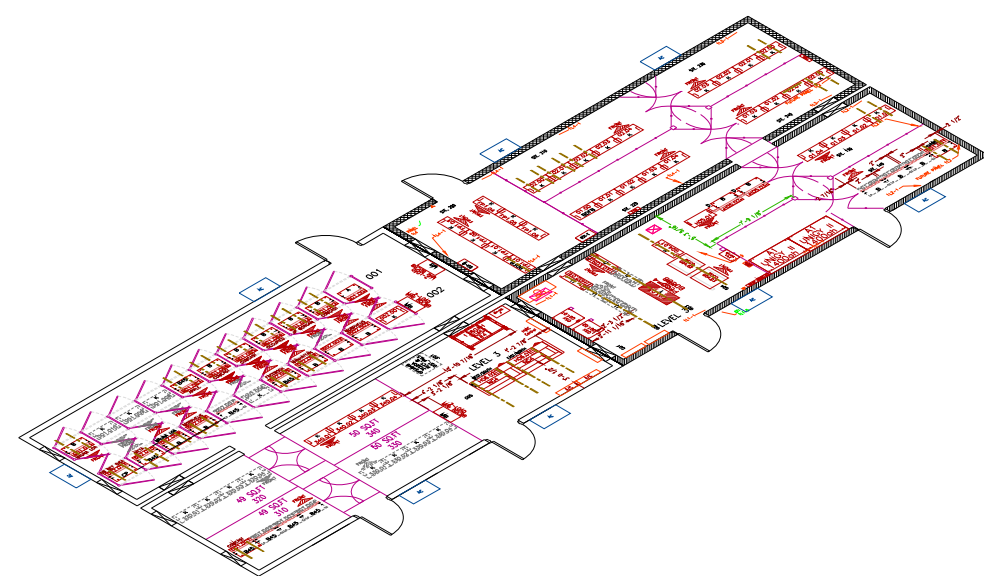


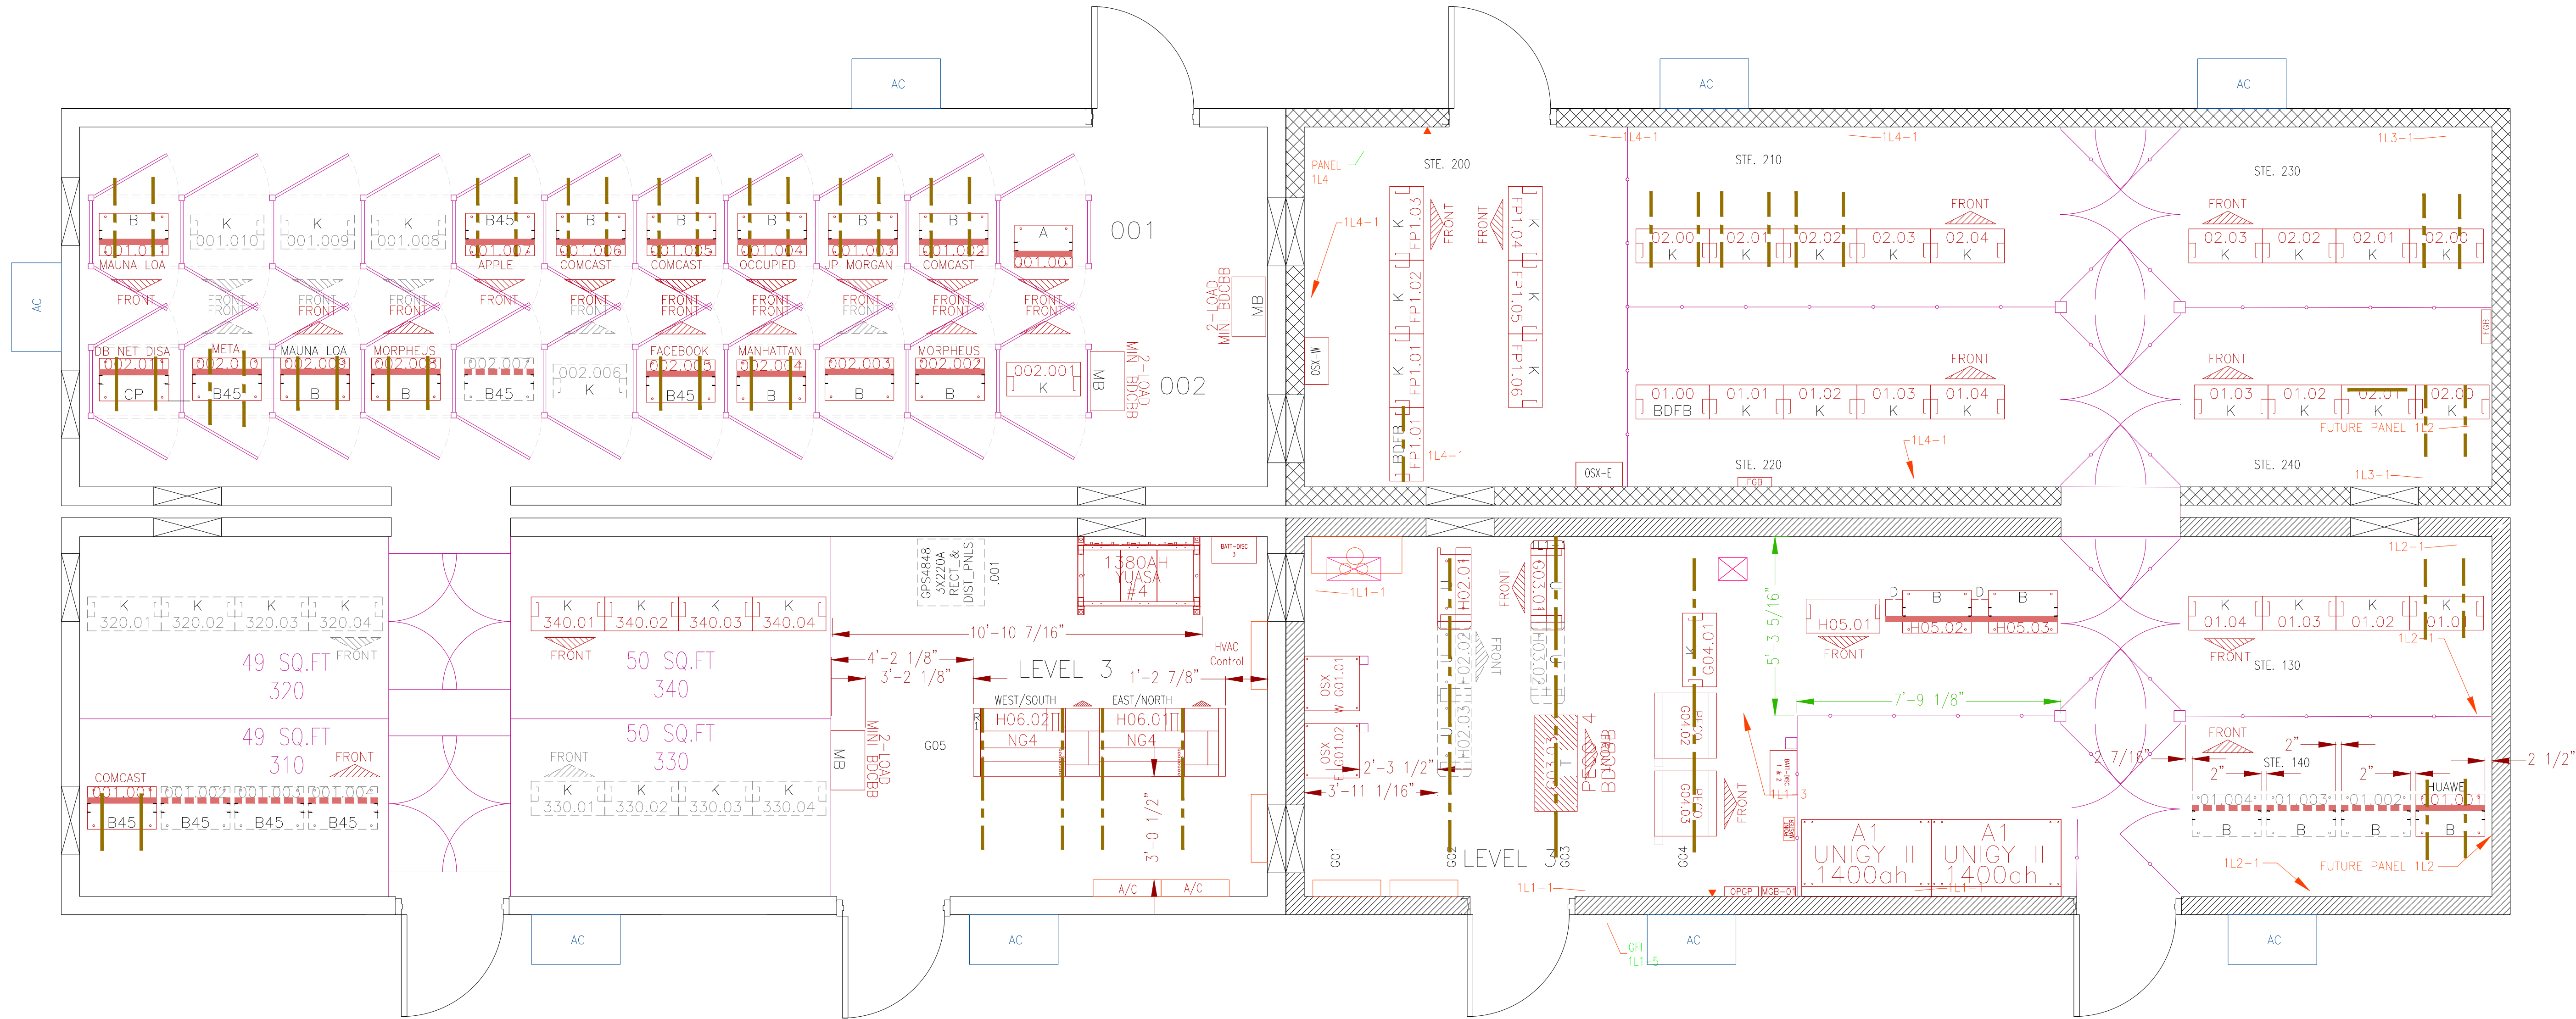

FRONT

ISO

RIGHT

VERSIONS				
VERSION: 11	DATE: 14JUL16	ENG: PM: KWW	DRAFT: dp	
UPDATED TO NEW LEVEL 3 STANDARDS				
VERSION: 12	DATE: 22MAR17	ENG: JPM	PM: JAF	DRAFT: JPM
ADDED (1) 23" CP RACK AS 002.011 IN HUT 4 (420.11) FOR DB NETWORKS - DISA. WO# PLLKC001-COI-UNK200B-01 CSS# GOVDF50L3ILA N325942				
VERSION: 13	DATE: 24MAR17	ENG: JPM	PM: JAF	DRAFT: JPM
AS-BUILT (1) 23" CP RACK AS 001.002 IN HUT 4 (410.02) FOR COMCAST UNICORN. WO# PLLKC001-COI-COMCAST-01 CSS# COMCAST20L3ILA N304580				
VERSION: 14	DATE: 05APR17	ENG: JPM	PM: JAF	DRAFT: JPM
INSTALL 23" CHANNEL RELAY RACK IN ICC CAGE 001.003 (410.03) FOR JP MORGAN. W.O. # PLLKC001-COI-JPMR&P-01 CSS # COMCAST20L3ILA N332088				
VERSION: 15	DATE: 27APR17	ENG: JPM	PM: JAF	DRAFT: JPM
ADDED (2) 23" CHANNEL RELAY RACKS IN ICCs 001.005 & 001.006 IN HUT 4 (410.05 & 410.06) FOR COMCAST. WO# PLLKC001-COI-COMCAST-01 CSS# COMCAST40202RKLADIRFEED N337337				
VERSION: 16	DATE: 04MAY17	ENG: JPM	PM: JAF	DRAFT: JPM
INSTALL (2) NG4 OSX FRAMES WITH FOTSP BAYS IN HUT 3, POSITIONS H06.01 & H06.02 FOR PROJECT UNICORN. W.O. # PLLKC001-INI-ILANGA-01 CSS # Unicorn ILA NG4 216x216 N338961				
VERSION: 17	DATE: 13APR18	ENG: JPM	PM: JAF	DRAFT: JPM
ADDED 23" CHANNEL RELAY RACK IN ICC CAGE 001.007 (410.07) FOR APPLE. W.O. # PLLKC001-COI-APPLE-01 CSS # APPLE20L3FPLRNF45RU N402739				
VERSION: 18	DATE: 17JUL18	ENG: JPM	PM: JAF	DRAFT: JPM
ADDED 23" 45RU CHANNEL RELAY RACK IN ICC CAGE 002.002 (420.05) FOR FACEBOOK. W.O. # PLLKC001-COI-FACEBOOK-01 CSS # FACBK50FPL3RLNRF45RU N420544				
VERSION: 19	DATE: 20MAY21	ENG: JPM	PM: JAF	DRAFT: JPM
ADDED 23" 45RU CHANNEL RELAY RACK IN HUT 3, SUITE 310, RACK POSITION 001.001 (310.01) FOR COMCAST. W.O. # PLLKC001-COI-FACEBOOK-01 CSS # CMCST60FPL3RLNRF45RU N681318				
VERSION: 20	DATE: 21APR22	ENG: JPM	PM: JAF	DRAFT: CH
ADDED 23" CHANNEL RELAY RACK IN ICC CAGE 002.007 (420.07) FOR META. W.O. # PLLKC001-COI-METAR&P-01 CSS # FACBK-1RK-2X60FPL3RLNRF N748104				
VERSION: 21	DATE: 16JUN22	ENG: JPM	PM: JAF	DRAFT: CH
UPDATE LOCATION ADDED 23" CHANNEL RELAY RACK IN ICC CAGE 002.010 (420.10) FOR META. W.O. # PLLKC001-COI-METAR&P-01 CSS # FACBK-1RK-2X60FPL3RLNRF N748104				

LUMEN®

INFORMATION IN THIS DOCUMENT IS PROPRIETARY AND SHALL NOT BE USED, COPIED, REPRODUCED, OR DISCLOSED IN WHOLE OR IN PART WITHOUT WRITTEN CONSENT OF LUMEN TECHNOLOGIES, LLC.

APPROVAL 1:	DATE:	CLLI CODE/ADDRESS:
DRAWN BY:	CH	PLKCO01 1ST FLOOR 481 COUNTY LINE RD PALMER LAKE, CO
SIZE:	DRAWING TITLE:	ILA
CEILING HGT:	DRAWING NUMBER:	PLKCO01-FP-01-01-L3
SCALE:	RELEASED:	14JUL16
3/8"=1'	SHEET:	1 OF 1